

PERFORMANCE TEST REPORT

Rendered to:

CMI ARCHITECTURAL PRODUCTS, INC.

SERIES/MODEL: 278-SSG Awning Window

PRODUCT TYPE: Structurally Glazed Vent

Title	Summary of Results
Air Infiltration	0.06 cfm/ft ²
Water Resistance Test Pressure	10.50 psf
Uniform Load Deflection Test Pressure	±70.0 psf
Uniform Load Structural Test Pressure	±105.0 psf
Forced Entry Resistance	Grade 10

Reference should be made to ATI Report No. 62662.01-201-44 for complete test specimen description and data.

PERFORMANCE TEST REPORT

Rendered to:

CMI ARCHITECTURAL PRODUCTS, INC.
2800 Freeway Boulevard
Minneapolis, Minnesota 55430

Report No.: 62662.01-201-44
Test Date: 02/02/06
Report Date: 03/15/07
Expiration Date: 02/02/10

Project Summary: Architectural Testing, Inc. (ATI) was contracted by CMI Architectural Products, Inc to perform testing on a Series 278-SSG Awning, Structurally Glazed Awning window. Test specimen description and results are reported herein.

Test Method(s): The test specimen was evaluated in accordance with the following:

ASTM E 283-99, Test Method for Determining Rate of Airflow Through Exterior Windows, Curtain Walls and Doors Under Specified Pressure Differences Across the Specimen

ASTM E 330-97e1, Test Method for Structural Performance of Exterior Windows, Curtain Walls and Doors by Uniform Static Air Pressure Difference

ASTM E 331-00, Test Method for Water Penetration of Exterior Windows, Curtain Walls and Doors by Uniform Static Air Pressure Difference

ASTM E 547-00, Test Method for Water Penetration of Exterior Windows, Curtain Walls and Doors by Cyclic Static Air Pressure Difference

ASTM F 588-97, Test Methods for Resistance of Window Assemblies to Forced Entry Excluding Gazing

Test Specimen Description:

Series/Model: 278-SSG Awning

Product Type: Structurally Glazed Awning

Overall Size: 5' 0" wide by 2' 8" high

Test Specimen Description: (Continued)

Sash Size: 4' 11-5-9/16" wide by 2' 7-9/16" high

Overall Area: 13.4 ft²

Finish: All aluminum was anodized.

Glazing Details: The unit was glazed with 1" insulated glass comprised of two 1/4" tempered sheets separated by a stainless steel spacer. The glass was set from the exterior against a structural glazing tape and sealed on the interior and exterior with structural adhesive.

Weatherstripping:

<u>Description</u>	<u>Quantity</u>	<u>Location</u>
1/4" EPDM blade seal	1 Row	Sash perimeter
3/16" hollow poly-vinyl bulb	2 Rows	Sash perimeter

Frame Construction: The frame was comprised of extruded aluminum that was miter-cut, secured with a staked corner key and sealed with silicone.

Sash Construction: The sash was comprised of extruded aluminum that was miter-cut, secured with a staked corner key and sealed with silicone.

Hardware:

<u>Description</u>	<u>Quantity</u>	<u>Location</u>
Stainless steel snubber	1	Midspan of frame head
Four-bar hinges	2	Jambs
Lock handles	2	Sill, 16" from each jamb

Installation: The frame was installed within an aluminum clad wood test buck. The 0.125" extruded aluminum cladding was secured to the buck with #8 by 1" screws spaced 2" from each corner and 18" on center on the head and sill and 2" and midspan on the jambs. The aluminum cladding was sealed to the buck with silicone.

The window frame was installed within the test buck with #8 by 2" screws spaced 3" from each end and 13" on center on the head and sill, and 3" and 11" on center on the jambs.

Test Results:

The results are tabulated as follows:

<u>Test Method</u>	<u>Title of Test</u>	<u>Results</u>
ASTM E 283	Air Infiltration	
	1.57 psf (25 mph)	0.06 cfm/ft ²
	6.24 psf (50 mph)	0.12 cfm/ft ²
ASTM E 547 and 331	Water Resistance	
	10.50 psf	No leakage
ASTM E 330	Uniform Load Deflection	
	(Deflections reported were taken on the sash stile)	
	(Loads were held for 60 seconds)	
	70.0 psf (positive)	0.02"
	70.0 psf (negative)	0.01"
ASTM E 330	Uniform Load Structural	
	(Permanent sets reported were taken on the sash stile)	
	(Loads were held for 10 seconds)	
	105.0 psf (positive)	0.02"
	105.0 psf (negative)	0.01"
ASTM F 588	Forced Entry Resistance	
	Type: B Grade: 10	
	Lock Manipulation Test	No entry
	Tests B1 through B3	No entry
	Lock Manipulation Test	No entry

Detailed drawings, representative samples of the test specimen, and a copy of this report will be retained by ATI for a period of four years from the original test date. This report is the exclusive property of the client so named herein and is applicable to the sample tested. Results obtained are tested values and do not constitute an opinion or endorsement by this laboratory. This report may not be reproduced, except in full, without approval of Architectural Testing, Inc.

For ARCHITECTURAL TESTING, INC:

Eric J. Schoenthaler
Project Manager

Daniel A. Johnson
Director of Regional Operations

EJS:mb
Attachment(s):
Appendix A: Drawings (1)

Revision Log

<u>Rev. #</u>	<u>Date</u>	<u>Page(s)</u>	<u>Revision(s)</u>
0	03/15/07	N/A	Original report issue.



Appendix A

Drawings




2 EA. AND 3015S12 4-BAR HINGE ASSEMBLIES
2 EA. TRUTH 2539 ANGLE BASE CAM HANDLES
1 EA. S.S. SASH SNUBBER




Test sample complies with these details.
Deviations are noted.

Report# 62662

Date 2-2-06

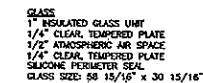Tech 

1. ALL TESTING SHALL BE IN ACCORDANCE WITH
AIAA 101-60 HEAVY COMMERCIAL WINDOW TESTING.
2. WIND SHAFTS SHALL BE CALIBRATED TO DETERMINE THE MAX-UM
PERFORMANCE CAPACITY AND RATING OF THE WINDOW
BEGINNING WITH HC-60.
3. AIR INFILTRATION SHALL BE CONDUCTED IN ACCORDANCE
WITH ASTM E283.
4. WATER PENETRATION SHALL BE CONDUCTED IN ACCORDANCE
WITH E331.
5. STORM SHIELD PERFORMANCE SHALL BE TESTED IN ACCORDANCE
WITH J350.
6. TESTING SHALL ALSO INCLUDE TORSION LOAD TEST & VERTICAL
DEFLECTION TEST.

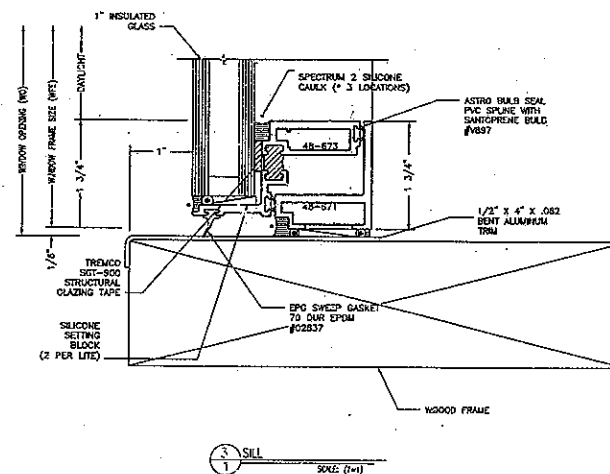

CMIArchitectural
CMI-ARCHITECTURAL PRODUCTS, INC.
806 4TH STREET
Desmet, South Dakota 57531-0475
TELEPHONE (605)554-3328
FAX (605)554-3077

THIS DRAWING IS PREPARED FOR THE SOLE USE OF OBTAINING PERMIT APPROVAL FROM LOCAL, STATE OR ARCHITECTURAL AGENCIES. NO RESPONSIBILITY FOR CLASS, SIZE, DETAILS OR MEASUREMENTS THAT CREATE ERRORS BY OTHER IMAGES THROUGH THE USE OF THESE DRAWINGS, PERMETER AND INSTRUMENTAL ANCHOR CONDITIONS ARE NOT THE RESPONSIBILITY OF ARCHITECTURAL ANCHOR DESIGNATIONS AND LOCATIONS ARE THE RESPONSIBILITY OF THE INSTALLER. THESE DRAWINGS AND THE APPLIES

PROJECT: 27BSSG-AWNING
PERFORMANCE TEST

ARCHITECT: BABY BOOGLER

CLIENT: LUMINOUS

REVISIONS

SYN	INT'L	DATE
-----	-------	------

--	--	--

DATE DRAWN:
8-23-05

DRAWN BY:
SCM

POI:

SCALE: AS NOTED

PROJECT MGR.
CARY GENE 'B

Est. 5.5.8

SHEET: _____

1